
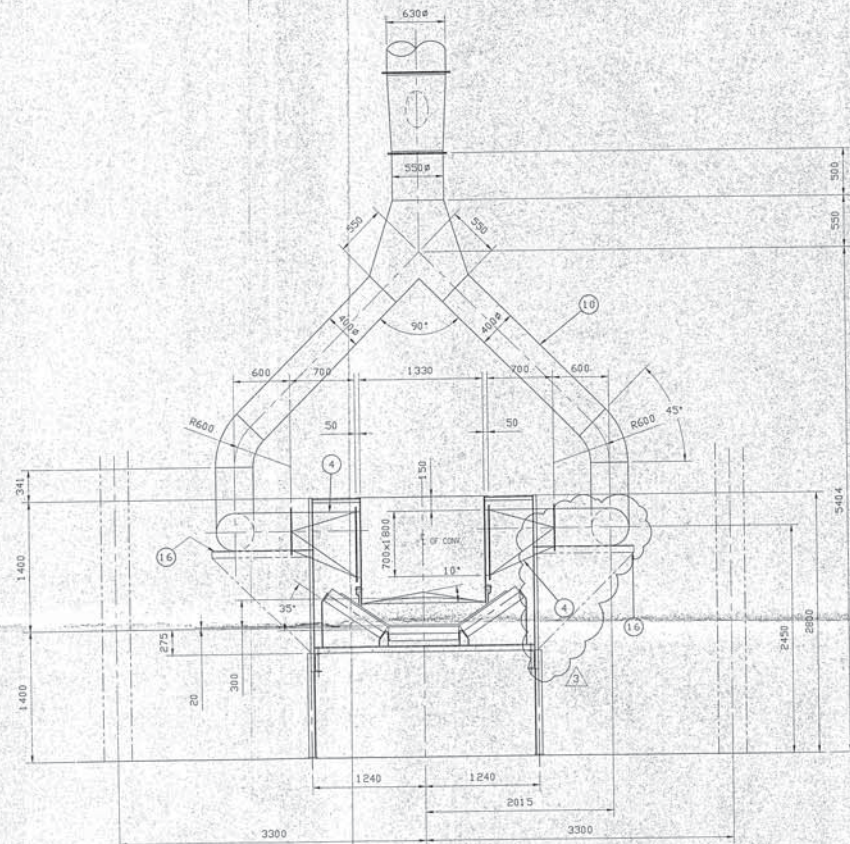
 BELT SIDE TRAVEL LIMIT SWITCHES (E NOS. REQ'D)


 EMERGENCY PULL-CORD LIMIT SWITCHES (4 NOS. REQ'D)

ITEM		QTY.		TOTAL AMT.		DESCRIPTION		PART NUMBER	
No.				(Kgs.)				Dwg. Number	




SECTION "D-D"


(SHEET 1)

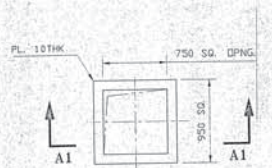


DETAIL '2'
(SHEET 1)

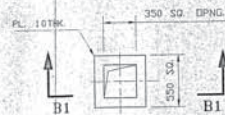


DETAIL '3'
(SHEET 1)

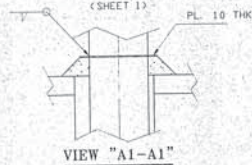


VIEW "A1-A1"

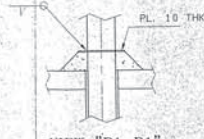

VIEW "B1-B1"

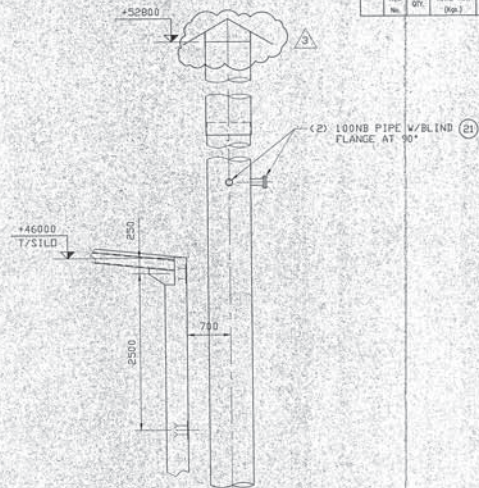

SECTION "C-C"
(SHEET 1)

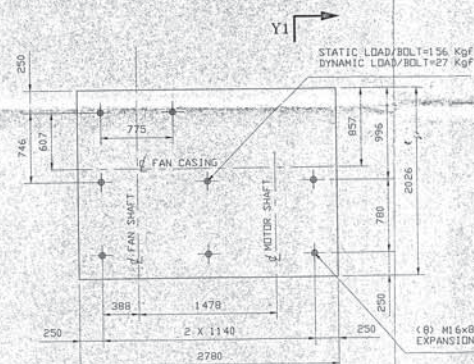

DETAIL '1'
 (SHEET 1)



VIEW "Y1-Y1"

(8) M16x80LG. GRIP
EXPANSION BOLT.

AS BUILT